


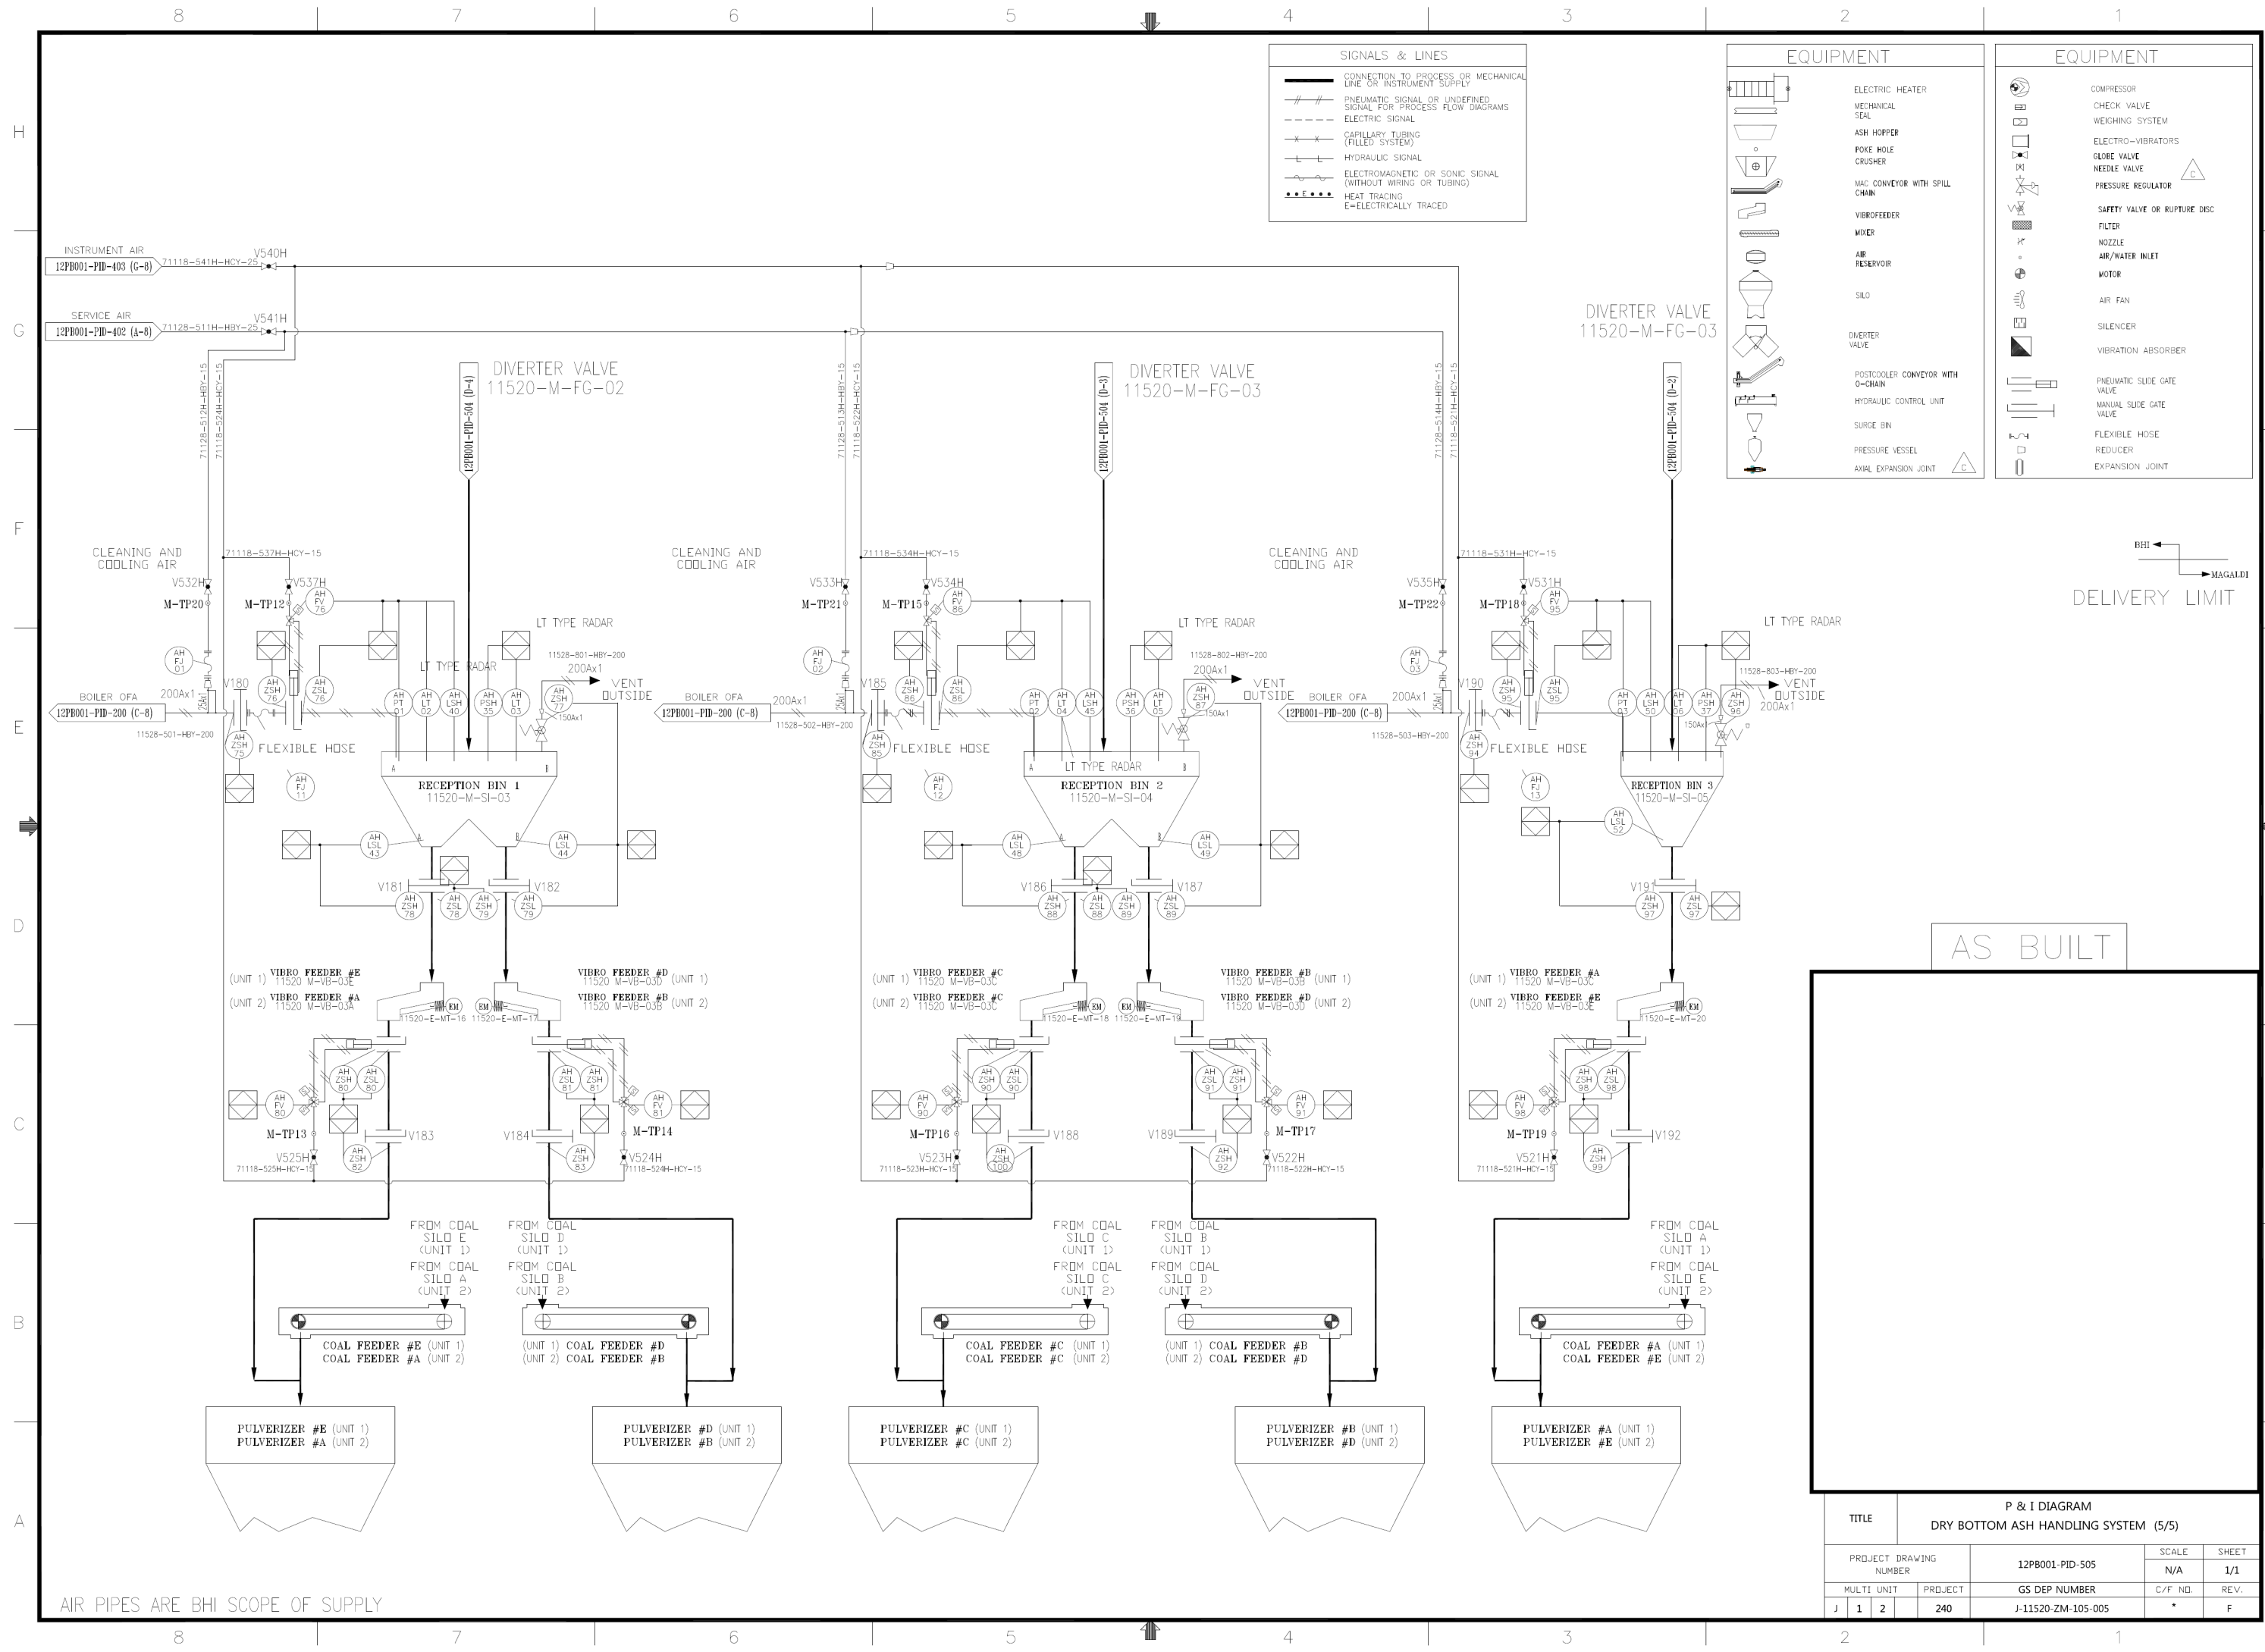

SIGNALS & LINES

- CONNECTION TO PROCESS OR MECHANICAL LINE OR INSTRUMENT SUPPLY
- PNEUMATIC SIGNAL OR UNDEFINED SIGNAL FOR PROCESS FLOW DIAGRAMS
- - - - - ELECTRIC SIGNAL
- . - . - CAPILLARY TUBING (FILLED SYSTEM)
- / - / - HYDRAULIC SIGNAL
- ~ - ~ - ELECTROMAGNETIC OR SONIC SIGNAL (WITHOUT WIRING OR TUBING)
- - HEAT TRACING
- E - ELECTRICALLY TRACED

EQUIPMENT

- ELECTRIC HEATER
- MECHANICAL SEAL
- ASH HOPPER
- POKE HOLE
- CRUSHER
- MAC CONVEYOR WITH SPILL CHAIN
- VIBROFEEDER
- MIXER
- AIR RESERVOIR
- SILLO
- DIVERTER VALVE
- POSTCOOLER CONVEYOR WITH O-CHAIN
- HYDRAULIC CONTROL UNIT
- SURGE BIN
- PRESSURE VESSEL
- AXIAL EXPANSION JOINT

EQUIPMENT

- COMPRESSOR
- CHECK VALVE
- WEIGHING SYSTEM
- ELECTRO-VIBRATORS
- GLOBE VALVE
- NEEDLE VALVE
- PRESSURE REGULATOR
- SAFETY VALVE OR RUPTURE DISC
- FILTER
- NOZZLE
- AIR/WATER INLET
- MOTOR
- AIR FAN
- SILENCER
- VIBRATION ABSORBER
- PNEUMATIC SLIDE GATE VALVE
- MANUAL SLIDE GATE VALVE
- FLEXIBLE HOSE
- REDUCER
- EXPANSION JOINT

AS BUILT				
P & I DIAGRAM DRY BOTTOM ASH HANDLING SYSTEM (5/5)				
TITLE		PROJECT DRAWING NUMBER		SHEET
		12PB001-PID-505		N/A
MULTI UNIT		PROJECT		REV.
J 1 2		240		F
		GS DEP NUMBER		C/F NO.
		J-11520-ZM-105-005		*

AIR PIPES ARE BHI SCOPE OF SUPPLY